


- Plan and Profile
- " 4 Plan and Profile of S.P. Railway Crossing
 - " 5 Standard Structures
 - " 1-9 Cross Sections

STATE OF CALIFORNIA
DEPARTMENT OF PUBLIC WORKS
DIVISION OF HIGHWAYS

PLAN AND PROFILE OF
STATE HIGHWAY
In Placer County, at Sheridan

Scales { Plan: 1 In. = 100 Ft.
 { Profile: Hor. 1 In. = 100 Ft. Vert. 1 In. = 5 Ft.

(being the detail plans of a portion of the route for the
State highway adopted by the California Highway Commission
October 5, 1915 and May 24, 1922)

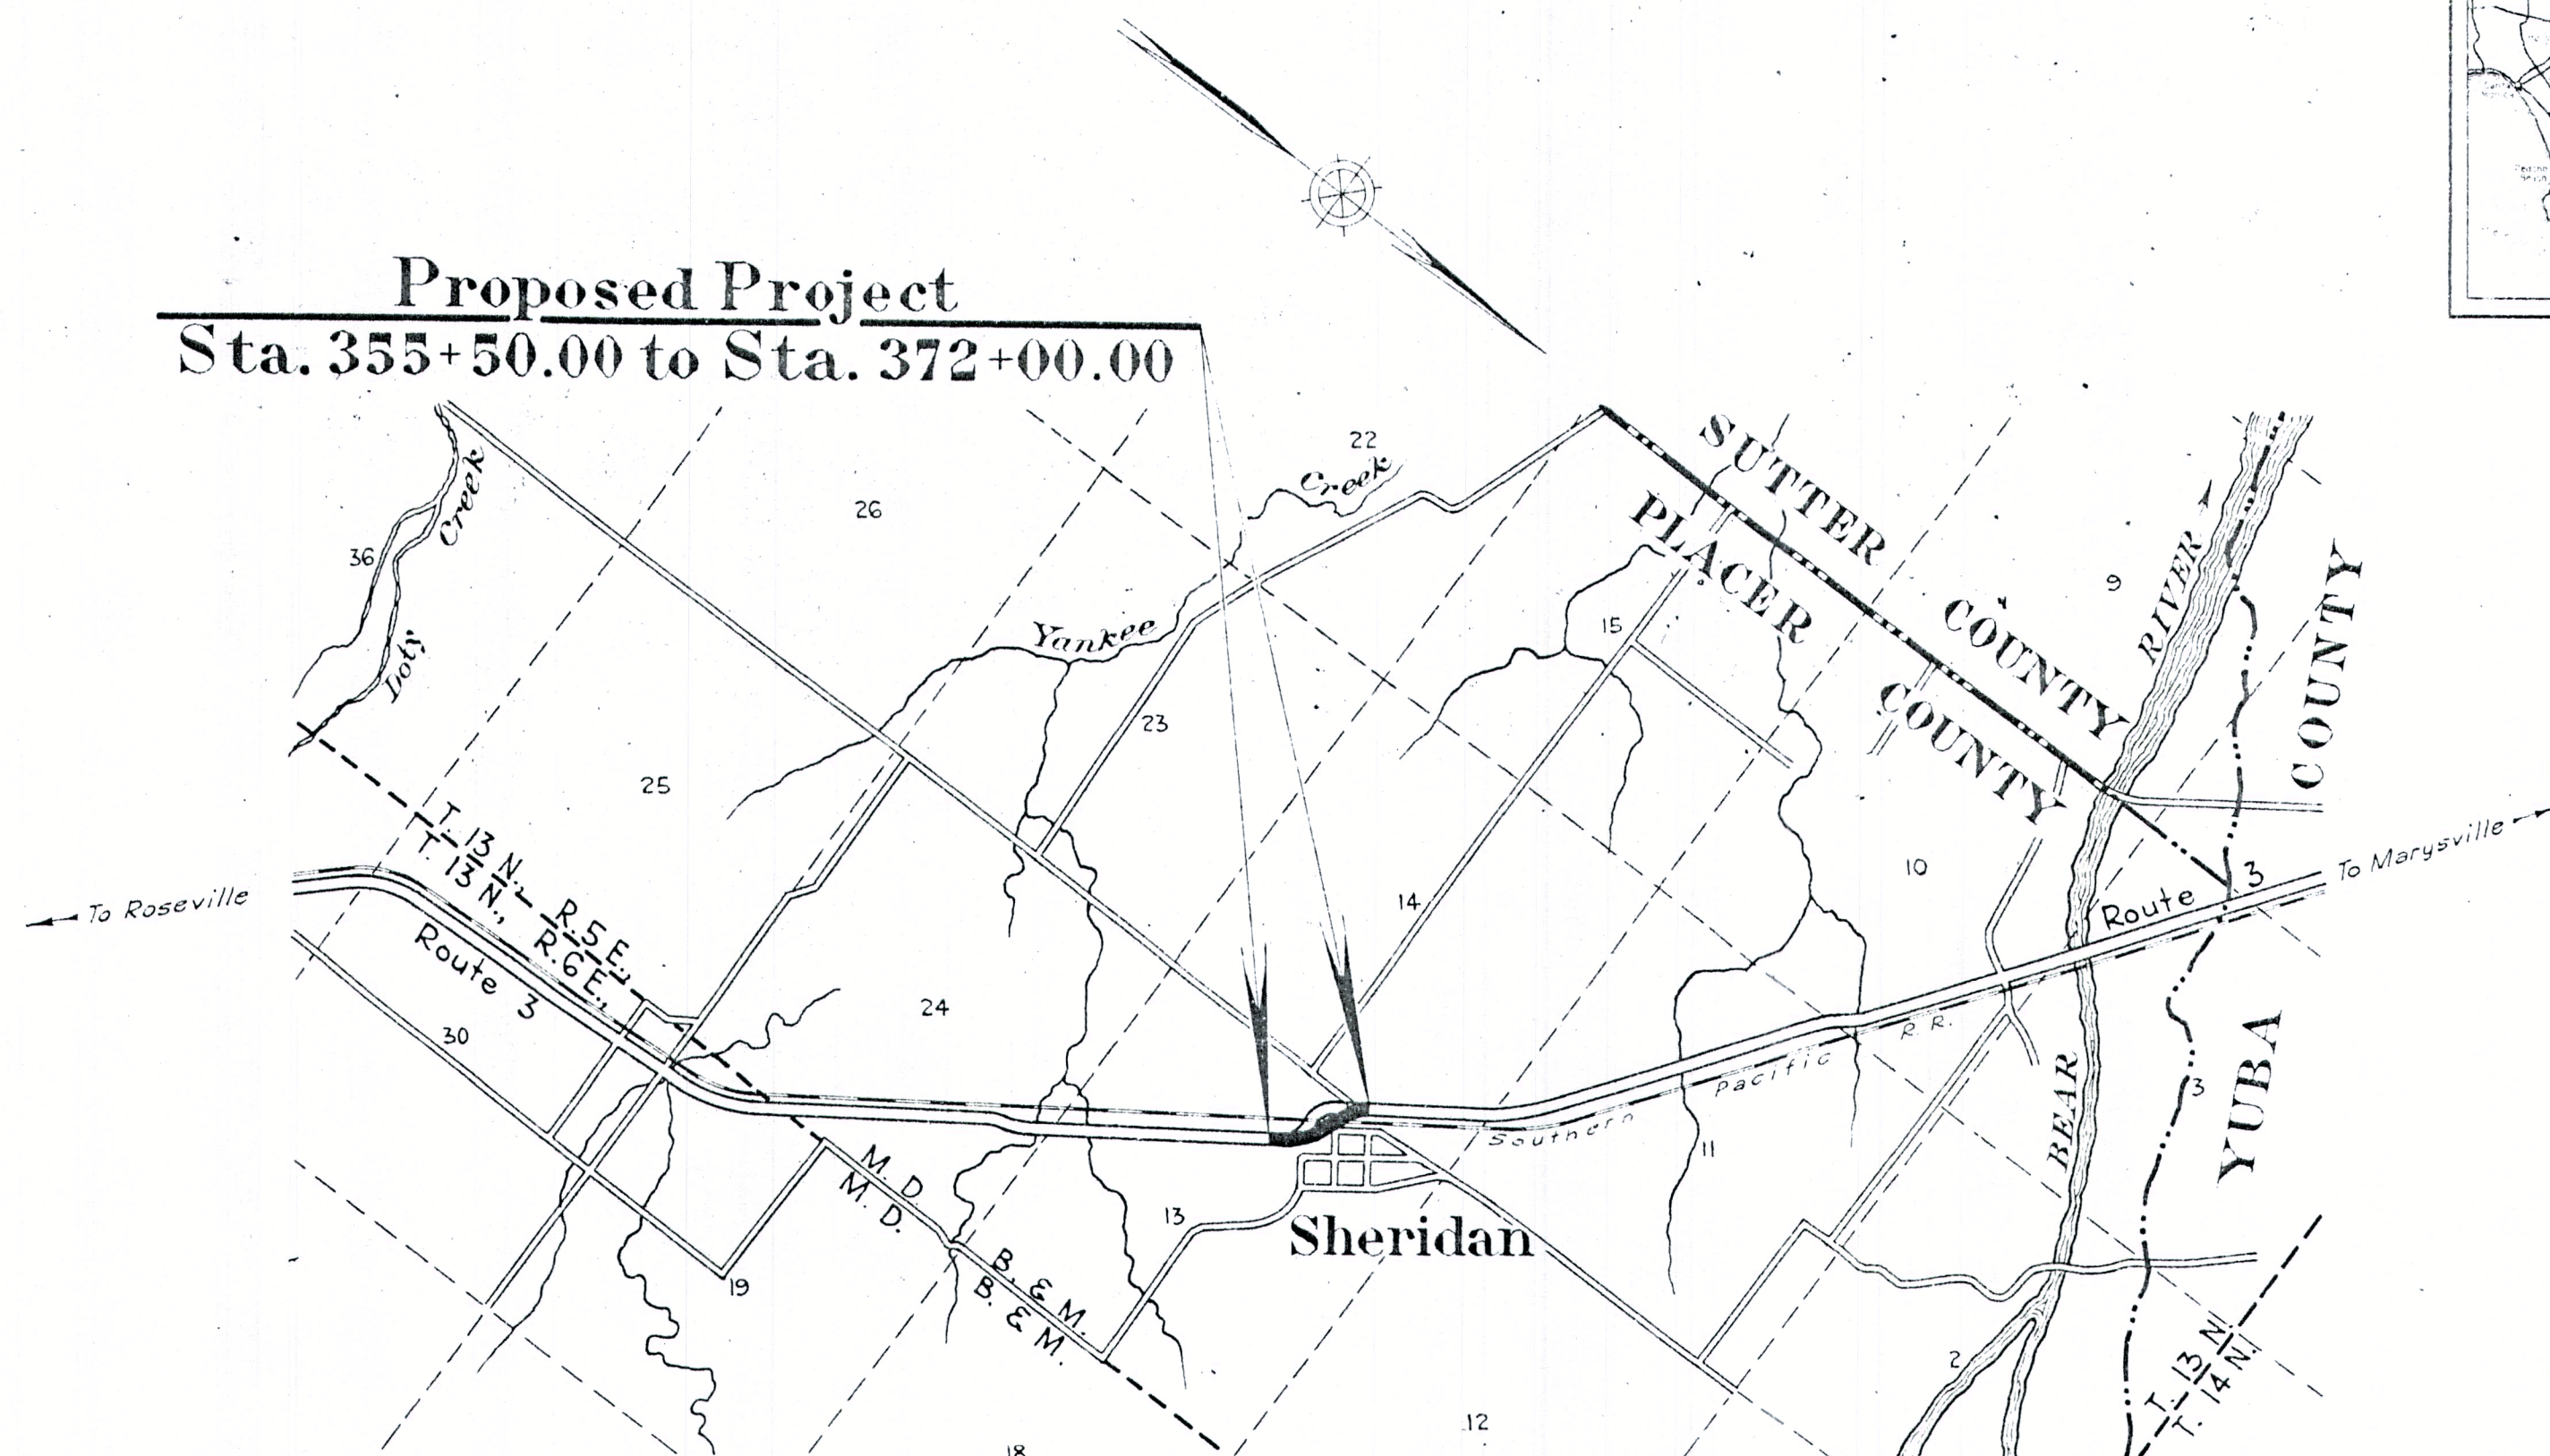

Base or Retaining Wall

Gravel

Concrete

Timber Bridge

Concrete Bridge

Water Power

Location of Telephone Pole

Scale in Feet

0 5000 10,000

Length of project - 1617.34 feet = 0.306 mile


CONT.

AS B
comp

T.13N.-R.5E.-M.D.B.&M.

DIST	COUNTY	ROUTE	SEC	SHEET	TOTAL SHEETS
III	PLA	3	B	3	5

C.F.W. Whitmore
Approved June 6, 1949
J.M. Wiskey
Dist. Eng. Dist. III

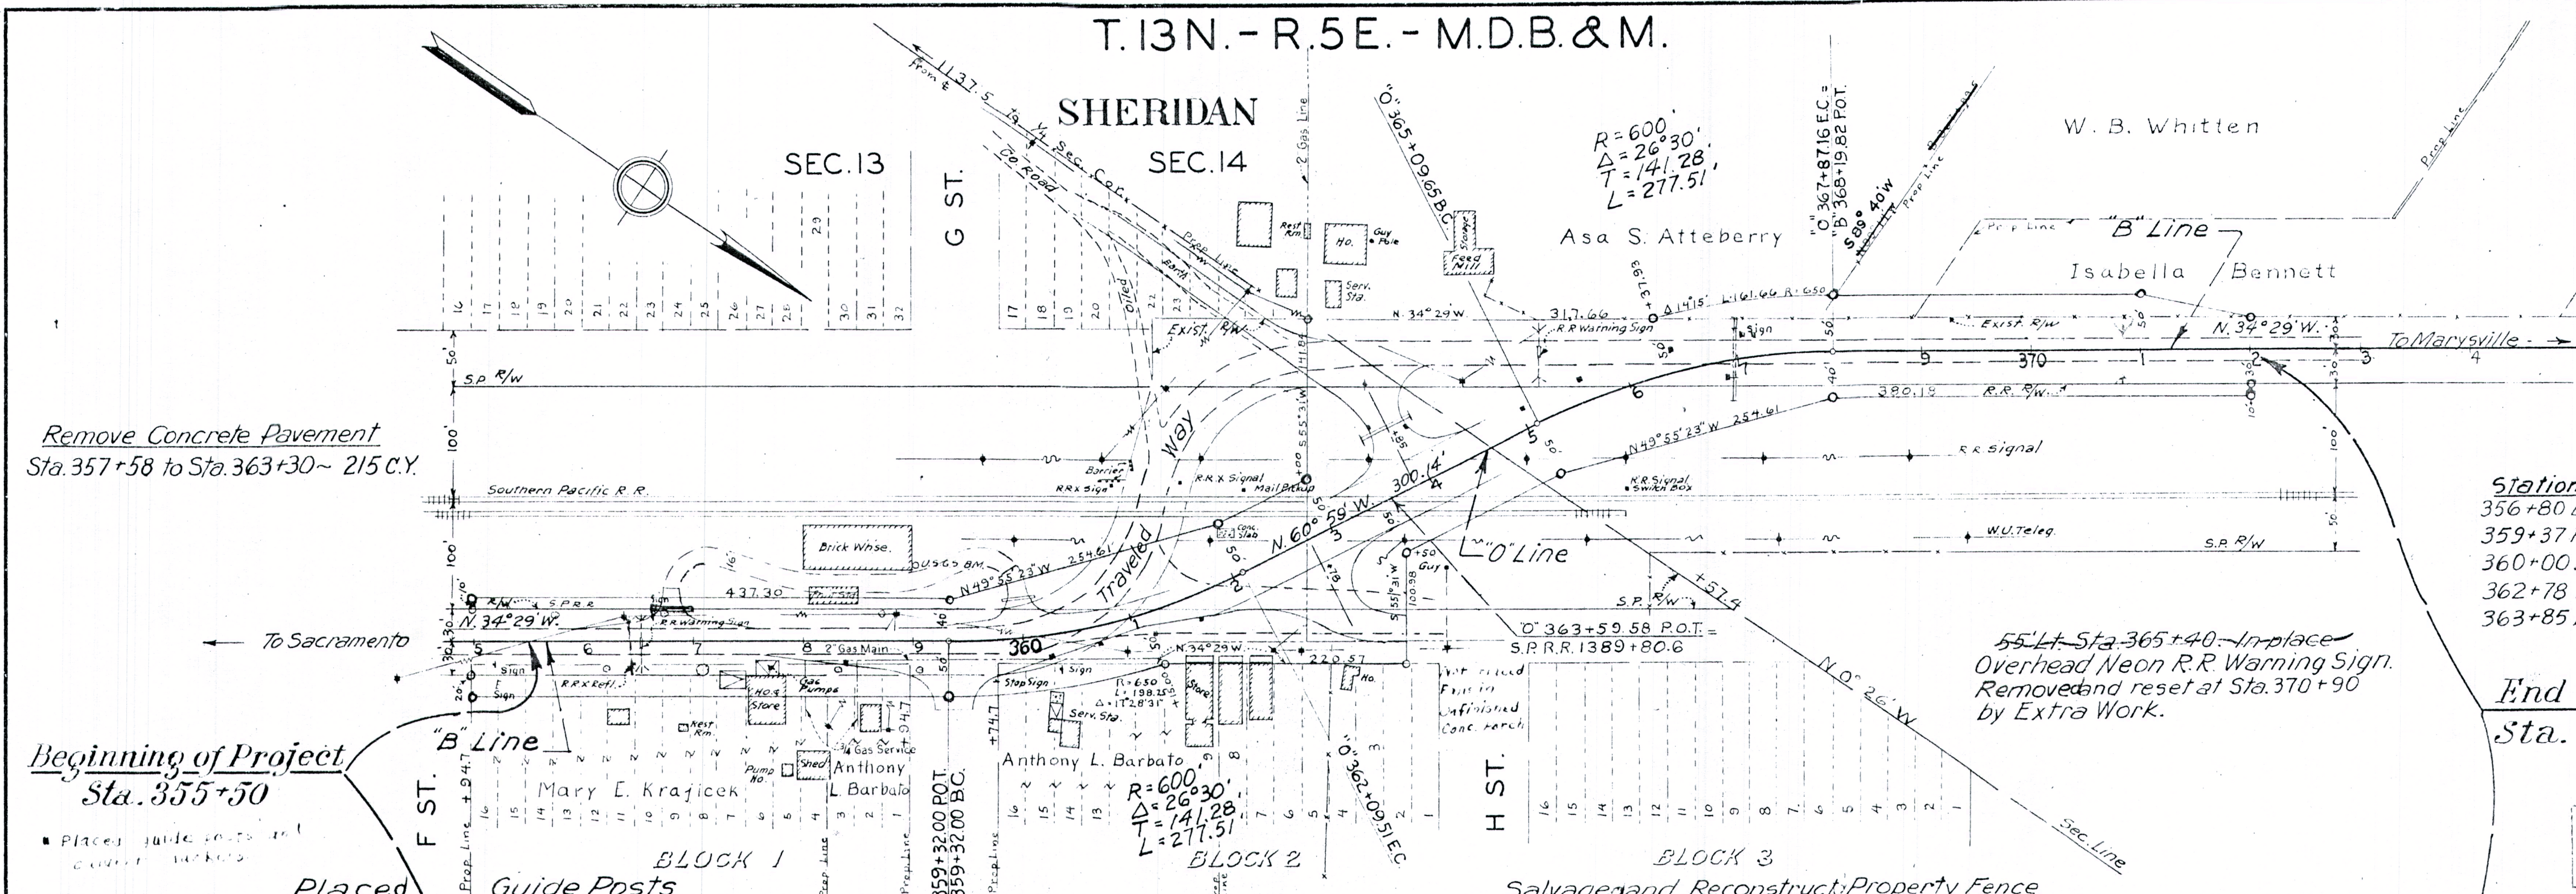


ROAD APPROACHES

Stations	Type "A" Imp. Bor.	C.I. "B" Double Sl. Ct. P.M.S. Per Tr.	Sq. Yds.
356+80 Lt.	24 C.Y.		82 Sq. Yds.
359+37 Rt.	76 "	578 Sq. Yds.	
360+00 Lt.	30 "		108 "
362+78 Rt.	303 "	660 "	751 "
363+85 Lt.	309 "	1253 "	

End of Project
Sta. 372+00

AS BUILT PLANS
completed: 1950

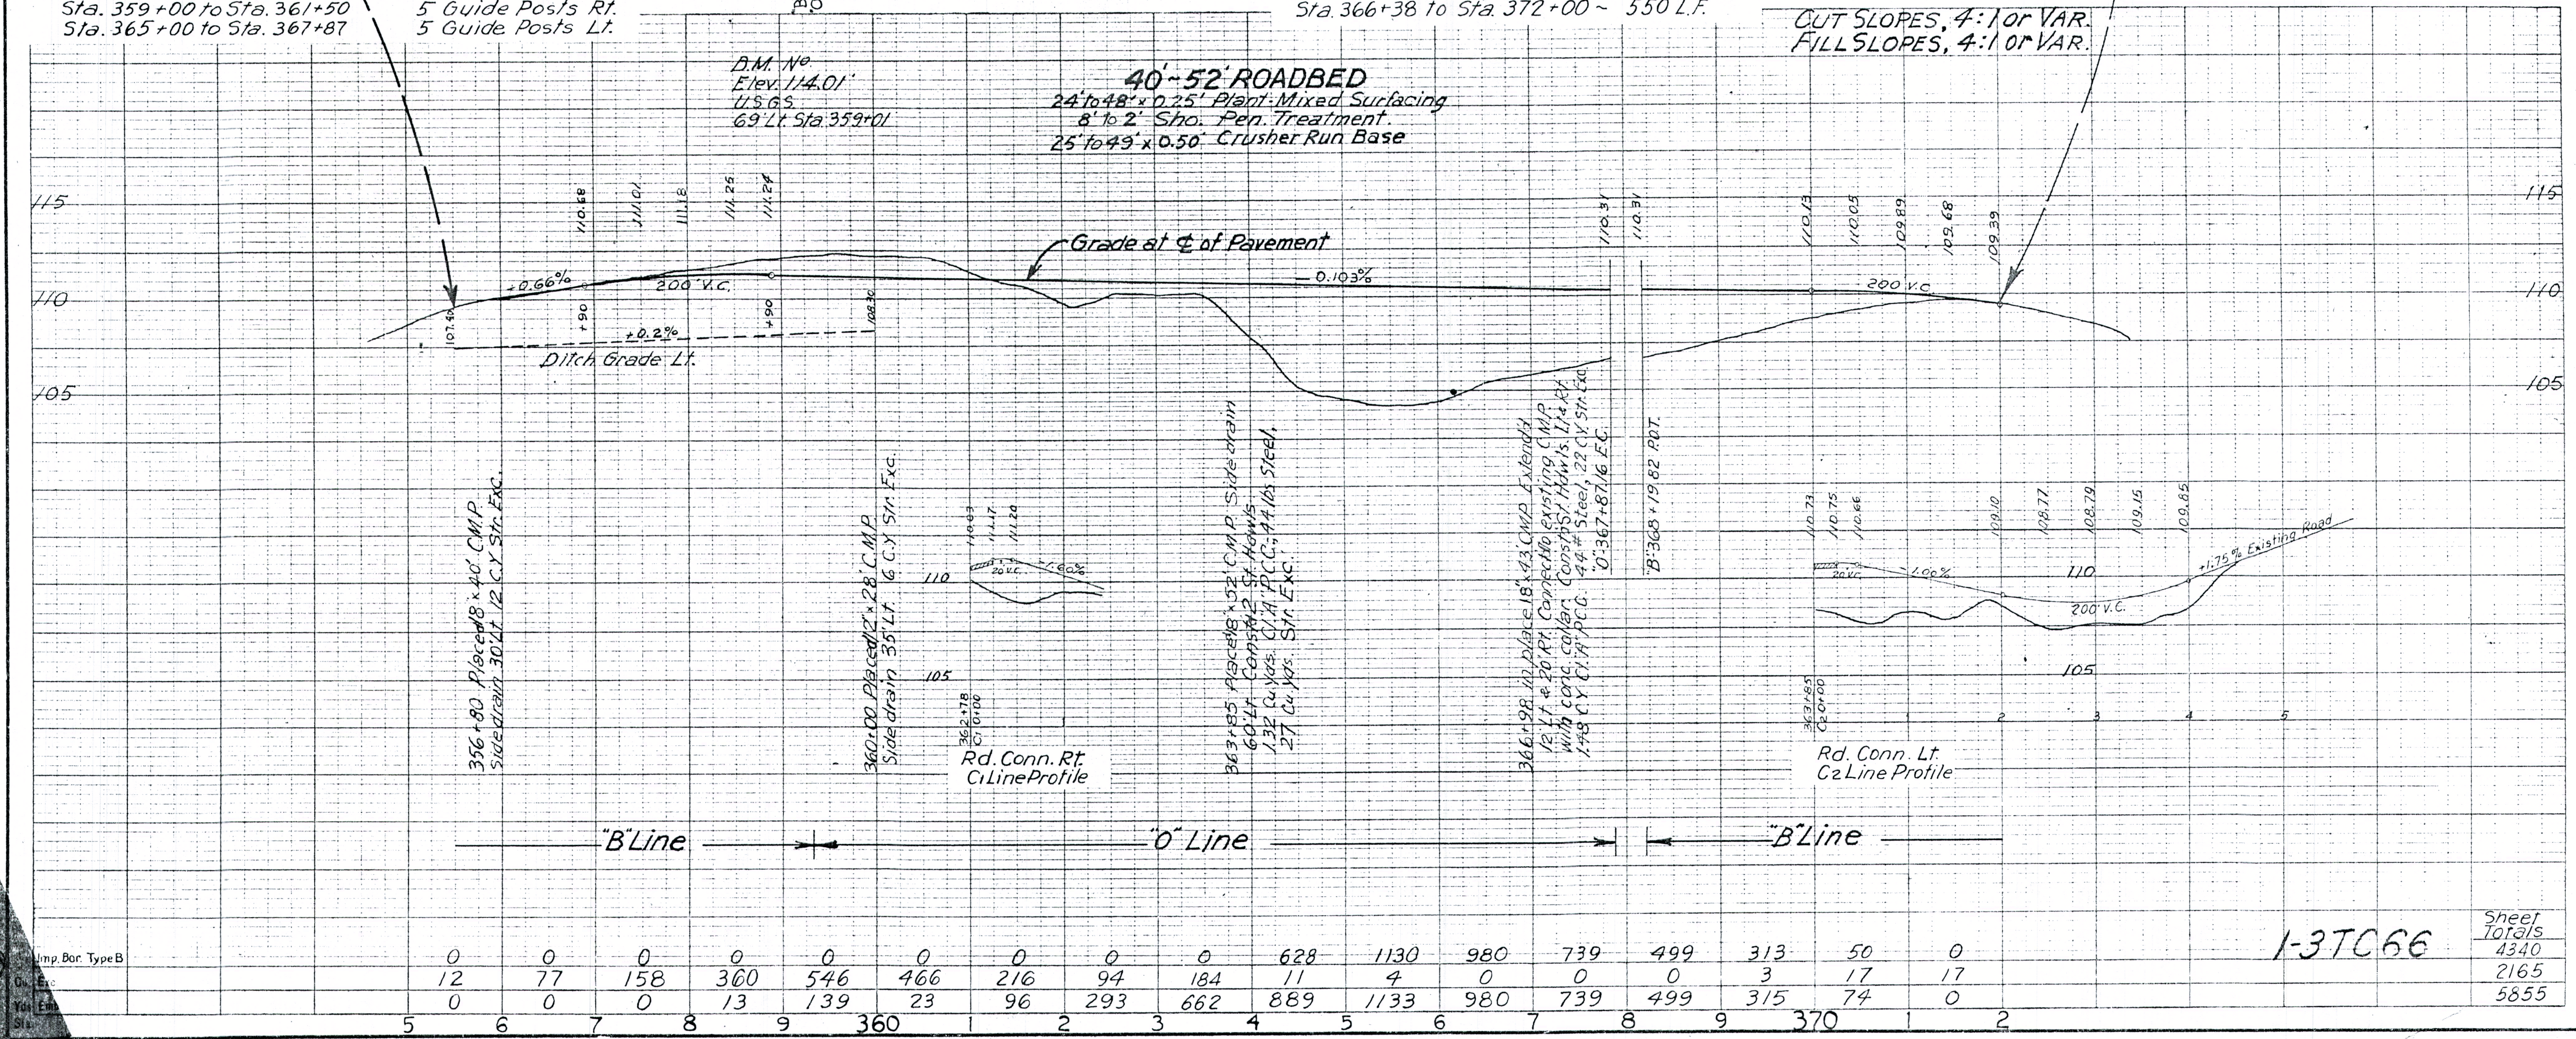

Imp. Bor. Type B	0	0	0	0	0	0	0	0	0	628	1130	980	739	499	313	50	0
Gr. Exc.	12	77	158	360	546	466	216	94	184	11	4	0	0	0	3	17	17
Sub. Exc.	0	0	0	13	139	23	96	293	662	889	1133	980	739	499	315	74	0
	5	6	7	8	9	360	1	2	3	4	5	6	7	8	9	370	2

1-3TC66
Sheet Totals
4340
2165
5855