

# INDEX OF SHEETS

|             |                                      |
|-------------|--------------------------------------|
| Sheet No. 1 | Title Sheet                          |
| " 2         | Typical Cross Section of Improvement |
| " 3         | Plan and Profile                     |
| " 4-5       | Standard Structures                  |
| " 1-3       | Cross Sections                       |



## STATE OF CALIFORNIA DEPARTMENT OF PUBLIC WORKS DIVISION OF HIGHWAYS

### PLAN AND PROFILE OF STATE HIGHWAY

In Placer County, at Deadman's Curve

Scales { Plan: 1 in. = 50 Ft.  
Profile: Hor. 1 in. = 50 Ft. Vert. 1 in. = 5 Ft.


(being the detail plans of a portion of the route for the State highway adopted by the California Highway Commission on September 23, 1919)

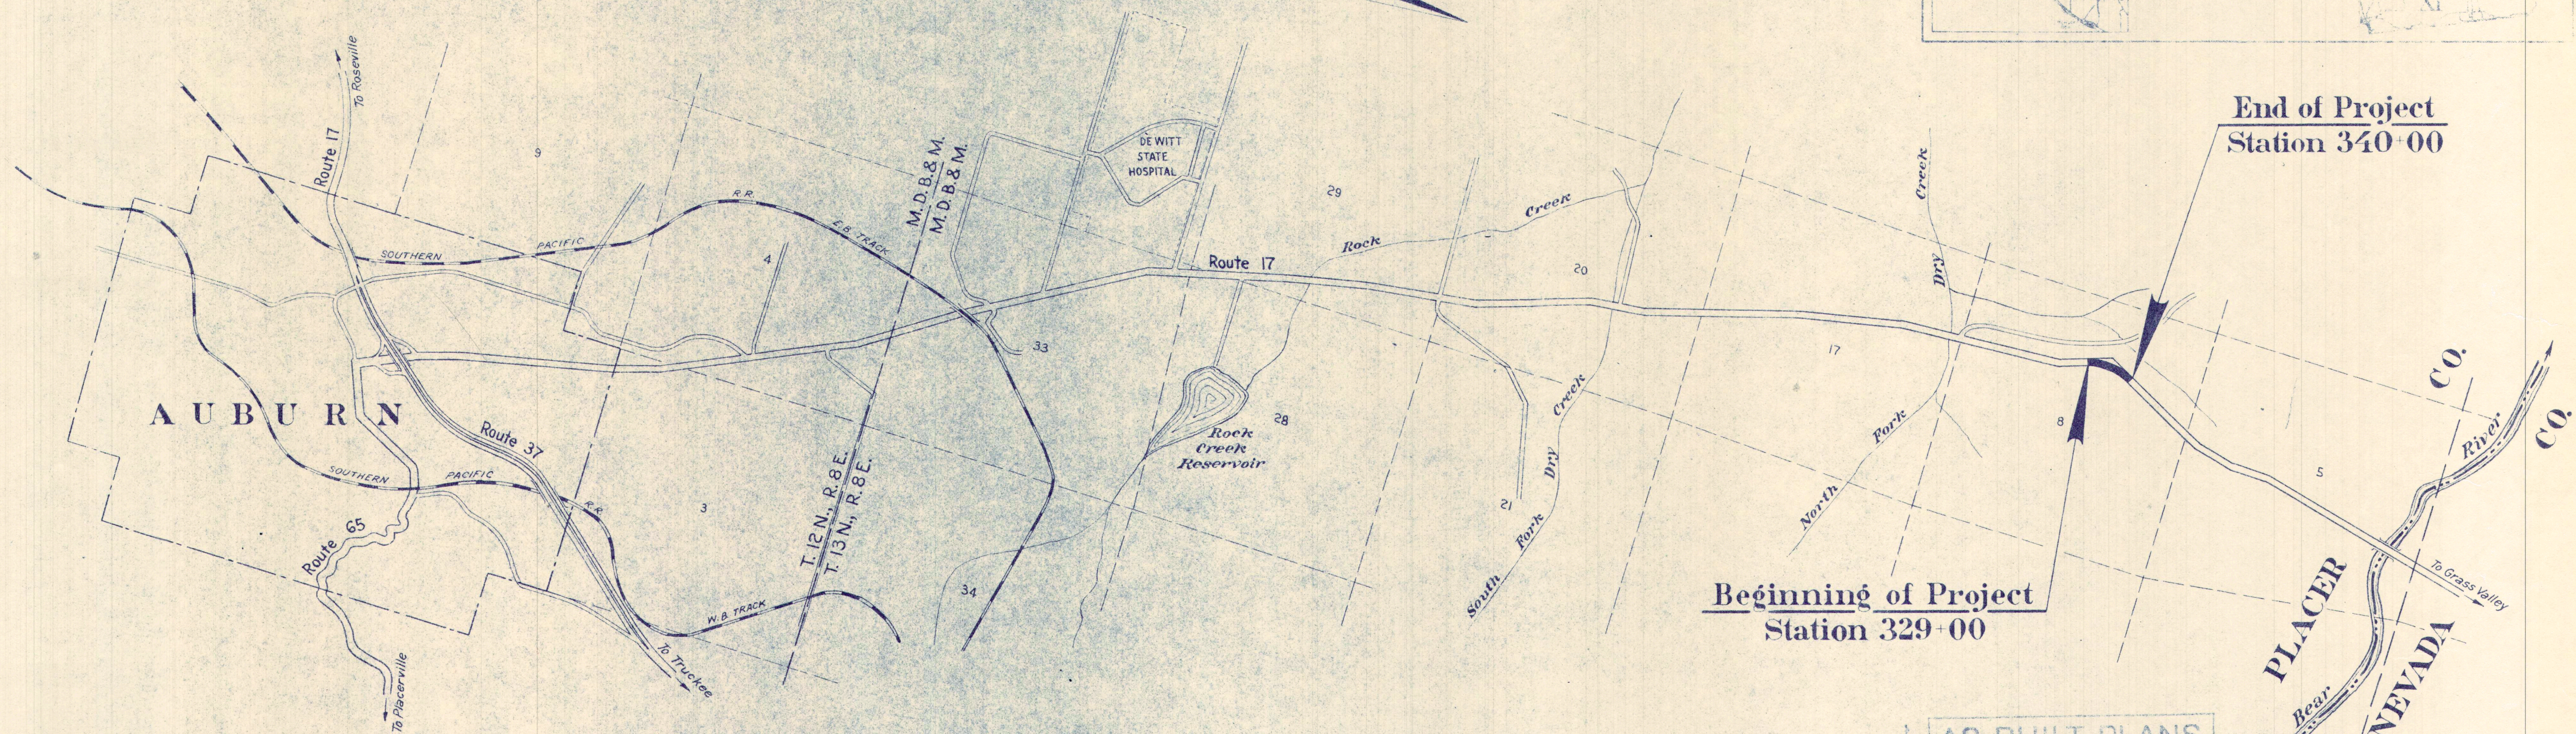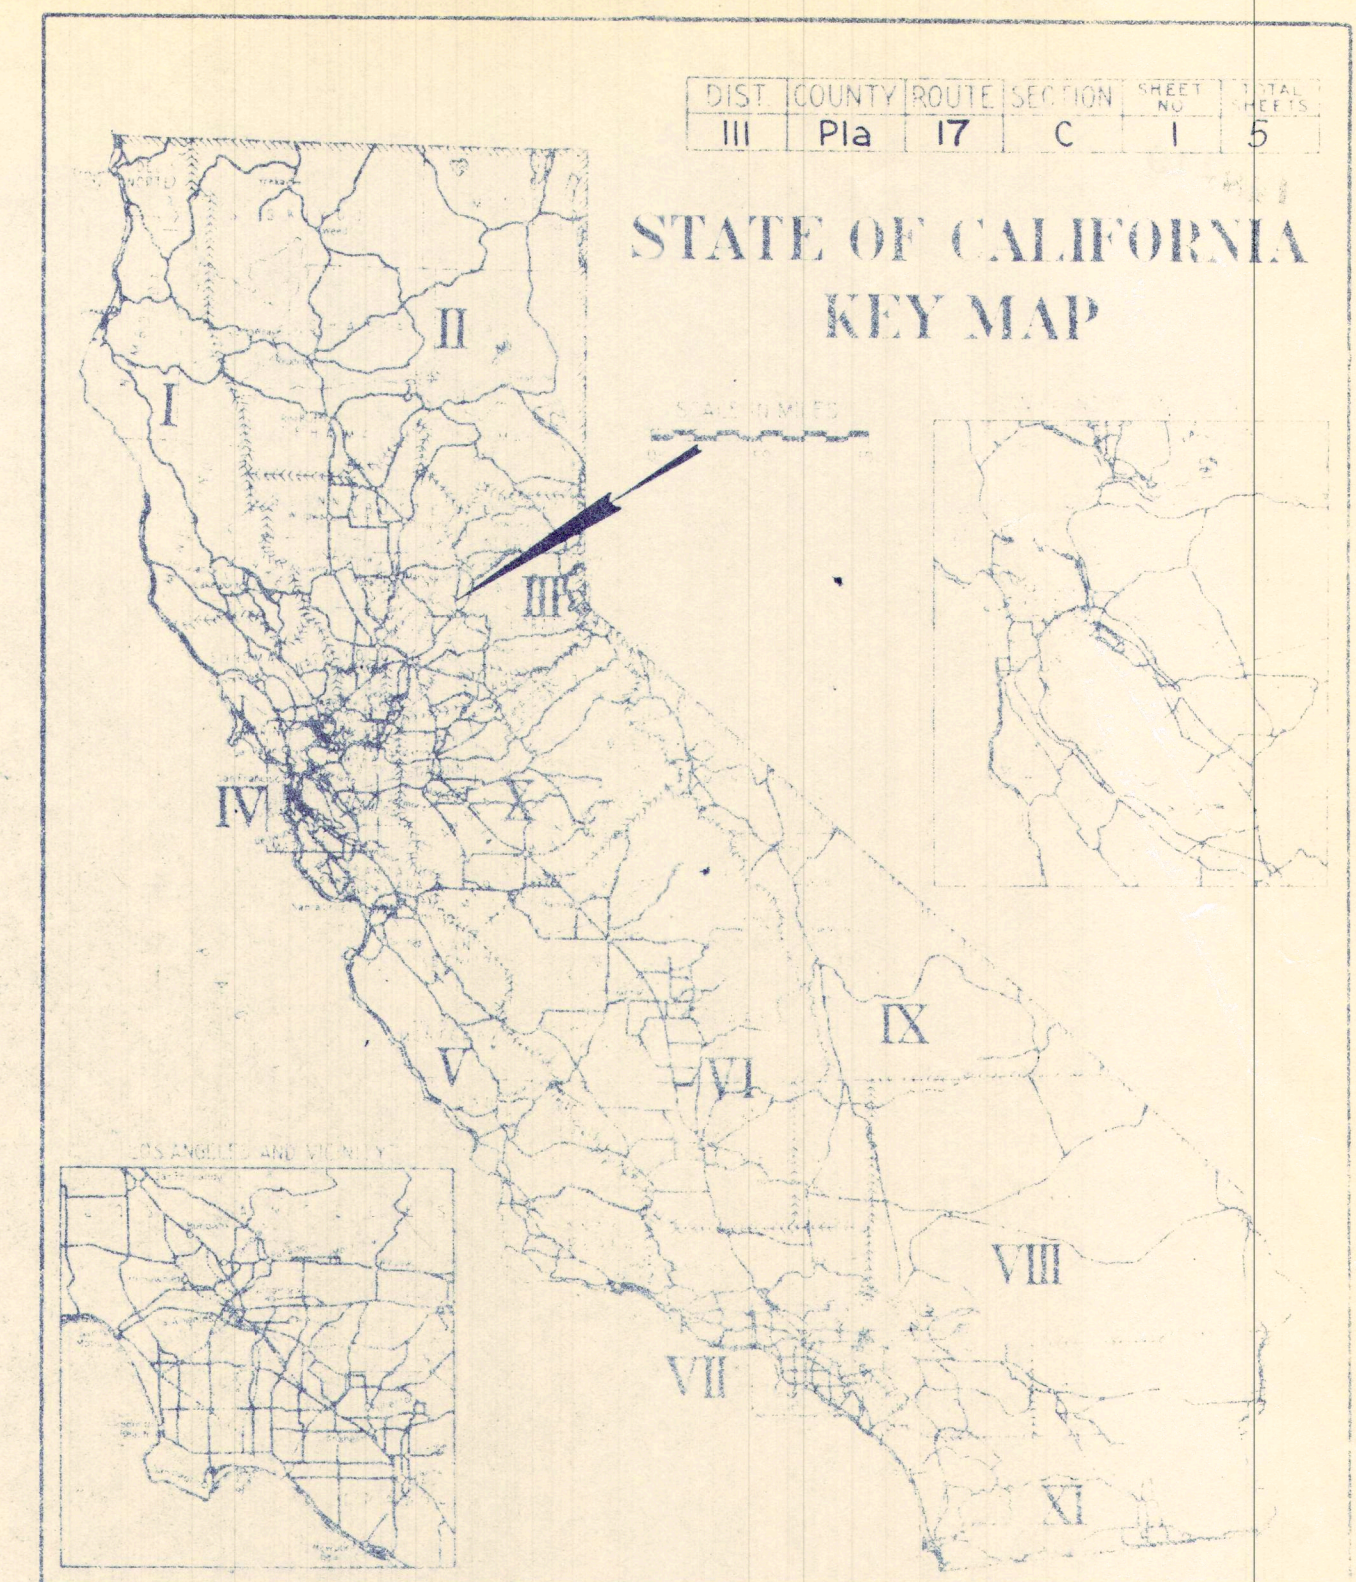

End of Project  
Station 340+00

Beginning of Project  
Station 329+00

AS BUILT PLANS  
completed: 1951  
Contract No. 51-3TC15

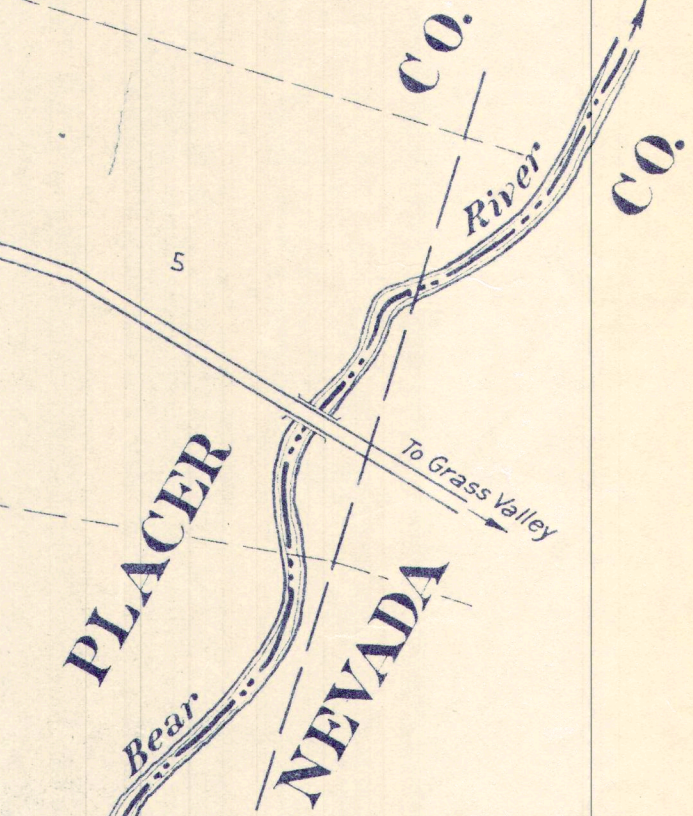

| CONVENTIONAL SIGNS  |                             |
|---------------------|-----------------------------|
| County Line         | Bank or Retaining Wall      |
| City or Town Limits | Levee                       |
| Township Line       | Culverts                    |
| Section Line        | Drop Inlet                  |
| Grant Line          | Trolley Pole                |
| Fence               | Power Pole                  |
| Guard Rail          | Power Tower                 |
| Unfenced Property   | Telegraph or Telephone Pole |
| Right of Way Line   | Marsh                       |
| Base or Survey Line |                             |
| Traveled Way        |                             |
| Railway Tracks      |                             |

Scale in Feet  
0 2000 4000 6000  
Length of Project 1072 feet - 0.203 mile


January 26, 1951  
C.H. Whitmore  
District Engineer  
Approved January 29, 1951  
J.M. McLean  
Assistant State Highway Engineer  
Approved January 29, 1951  
C.H. Purcell  
Director of Public Works

Dist. Eng. Dist. III  
 Approved January 29, 1951  
*J.W. Whaley*

T.13N.-R.8E.-M.D.B.&M.  
 Sec. 8

Placed ReflectORIZED Guide Posts  
 Sta. 329+00 to Sta. 339+00 - 10 posts - Lt.


Placed Culvert Markers  
 Sta. 334+50 - 10 Rt. & Lt.

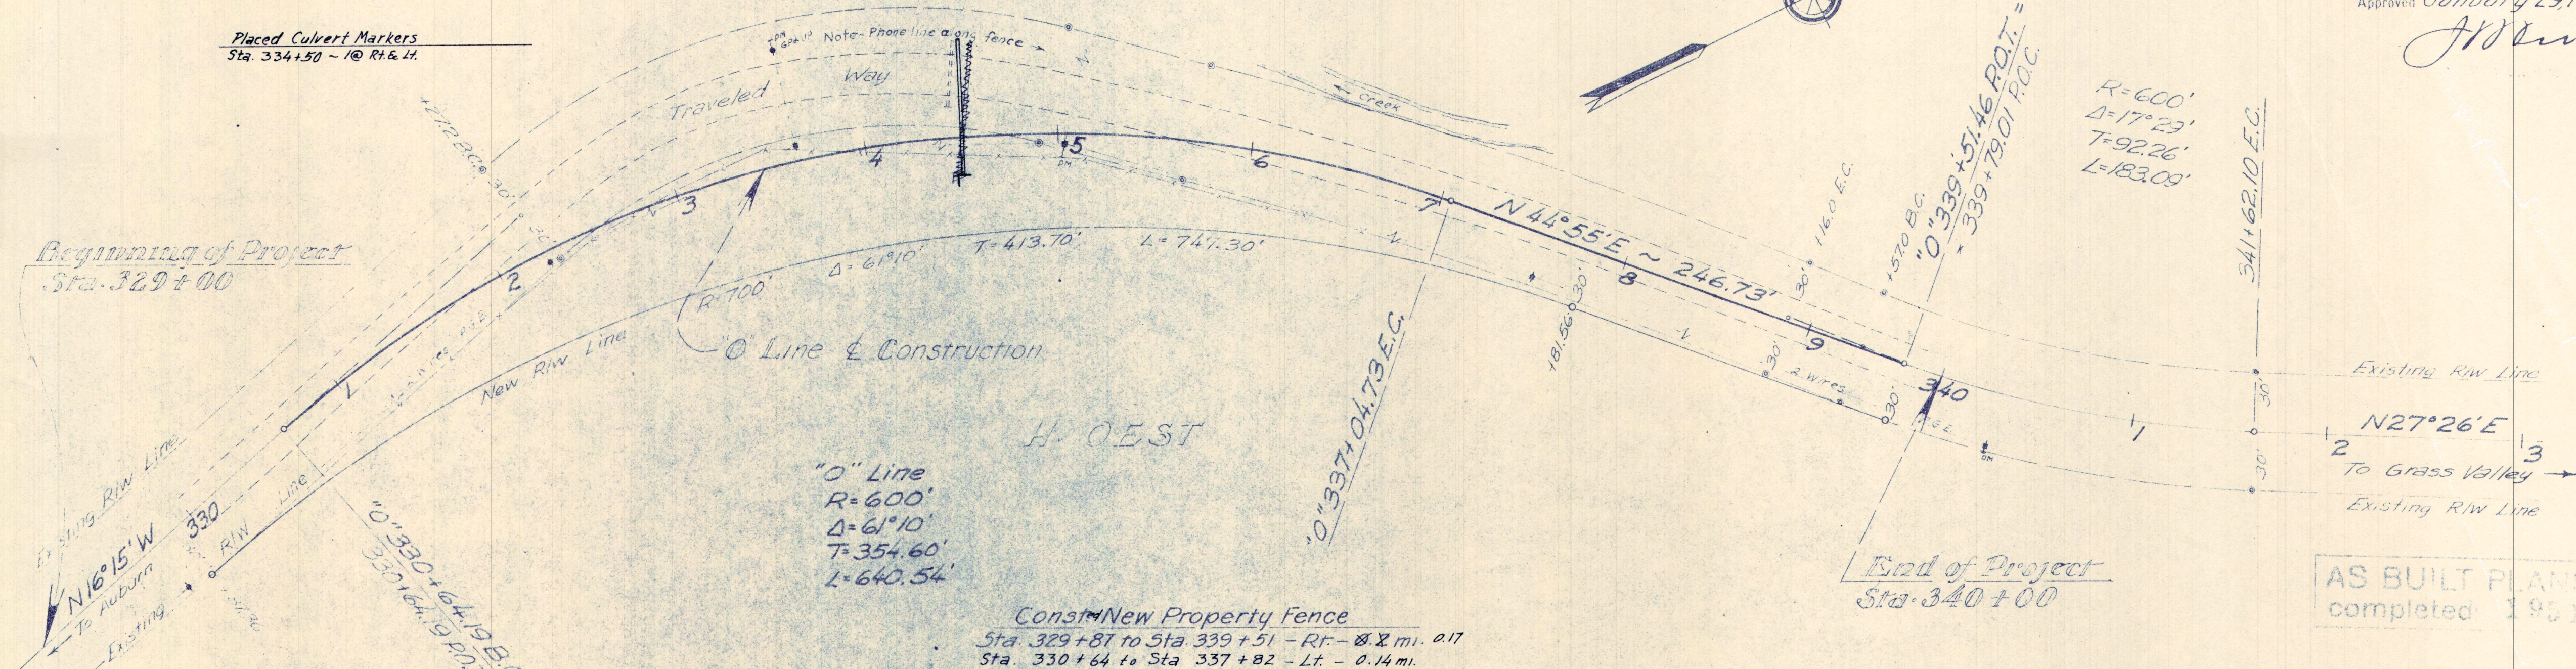

AS BUILT PLANS  
 completed 1951

CUT SLOPES - 1:1 max.  
 FILL SLOPES - 2:1 or var.

30' ROADBED  
 22' x 0.25' Plant Mix Surfacing

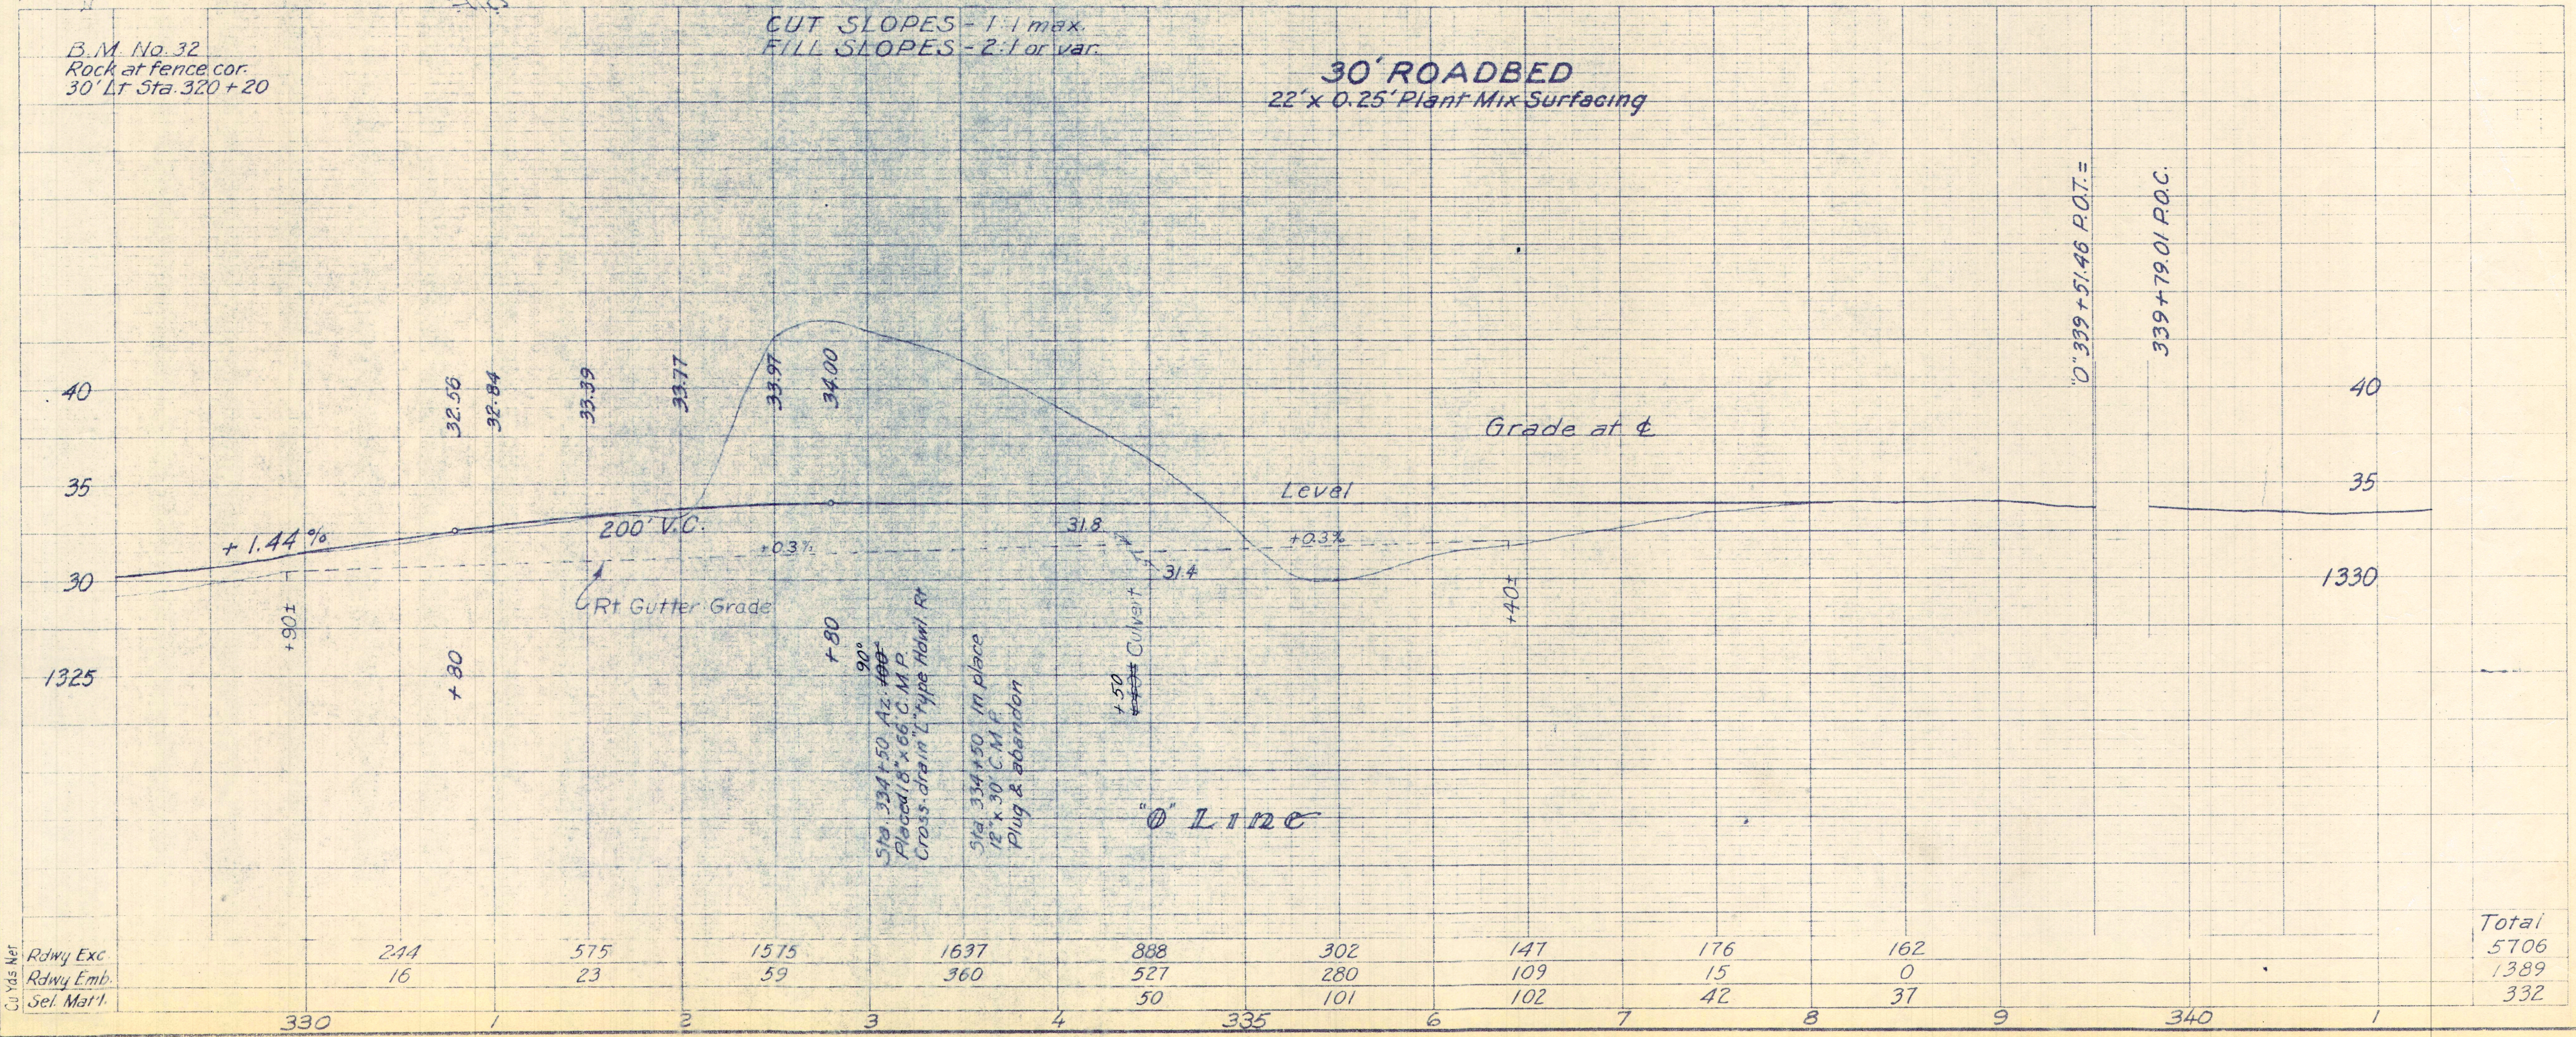

Cut & Fill  
 Rdwy Exc.  
 Rdwy Emb.  
 Sel. Mat'l.

|     |     |      |      |     |     |     |     |     |   |     |   |       |
|-----|-----|------|------|-----|-----|-----|-----|-----|---|-----|---|-------|
| 330 | 1   | 2    | 3    | 4   | 335 | 6   | 7   | 8   | 9 | 340 | 1 | Total |
| 244 | 575 | 1575 | 1637 | 888 | 302 | 147 | 176 | 162 |   |     |   | 5706  |
| 16  | 23  | 59   | 360  | 527 | 280 | 109 | 15  | 0   |   |     |   | 1389  |
|     |     |      |      | 50  | 101 | 102 | 42  | 37  |   |     |   | 332   |